


Mid Atlantic Rack w/ casters

WIRE CHART		
Speakers	WPW 25226	2 cond # 14awg
Video	Belden 1505a	Precision Coax
Proj Ctrl	WPW 25D291	Low cap, 2 cond w/ shield

APPROVALS DRAWN BY: P. Bailey 1-2-07 REVISION 1: P. Bailey 1-5-07 REVISION 2: P. Bailey 5-10-07 AS BUILT: P. Bailey 10-10-07		DATE 1-2-07 1-5-07 5-10-07 10-10-07		Holocaust Human Rights Center BBI ENGINEERING INC San Francisco, CA	
SIZE D	CODE IDENT	DRAWING NO. BLOCK DIAGRAM		Copyright © BBI Engineering, Inc. All rights reserved. Material contained in these drawings & specifications may not be used on other projects without written consent of BBI.	
SCALE none	SHEET 1 OF 1				

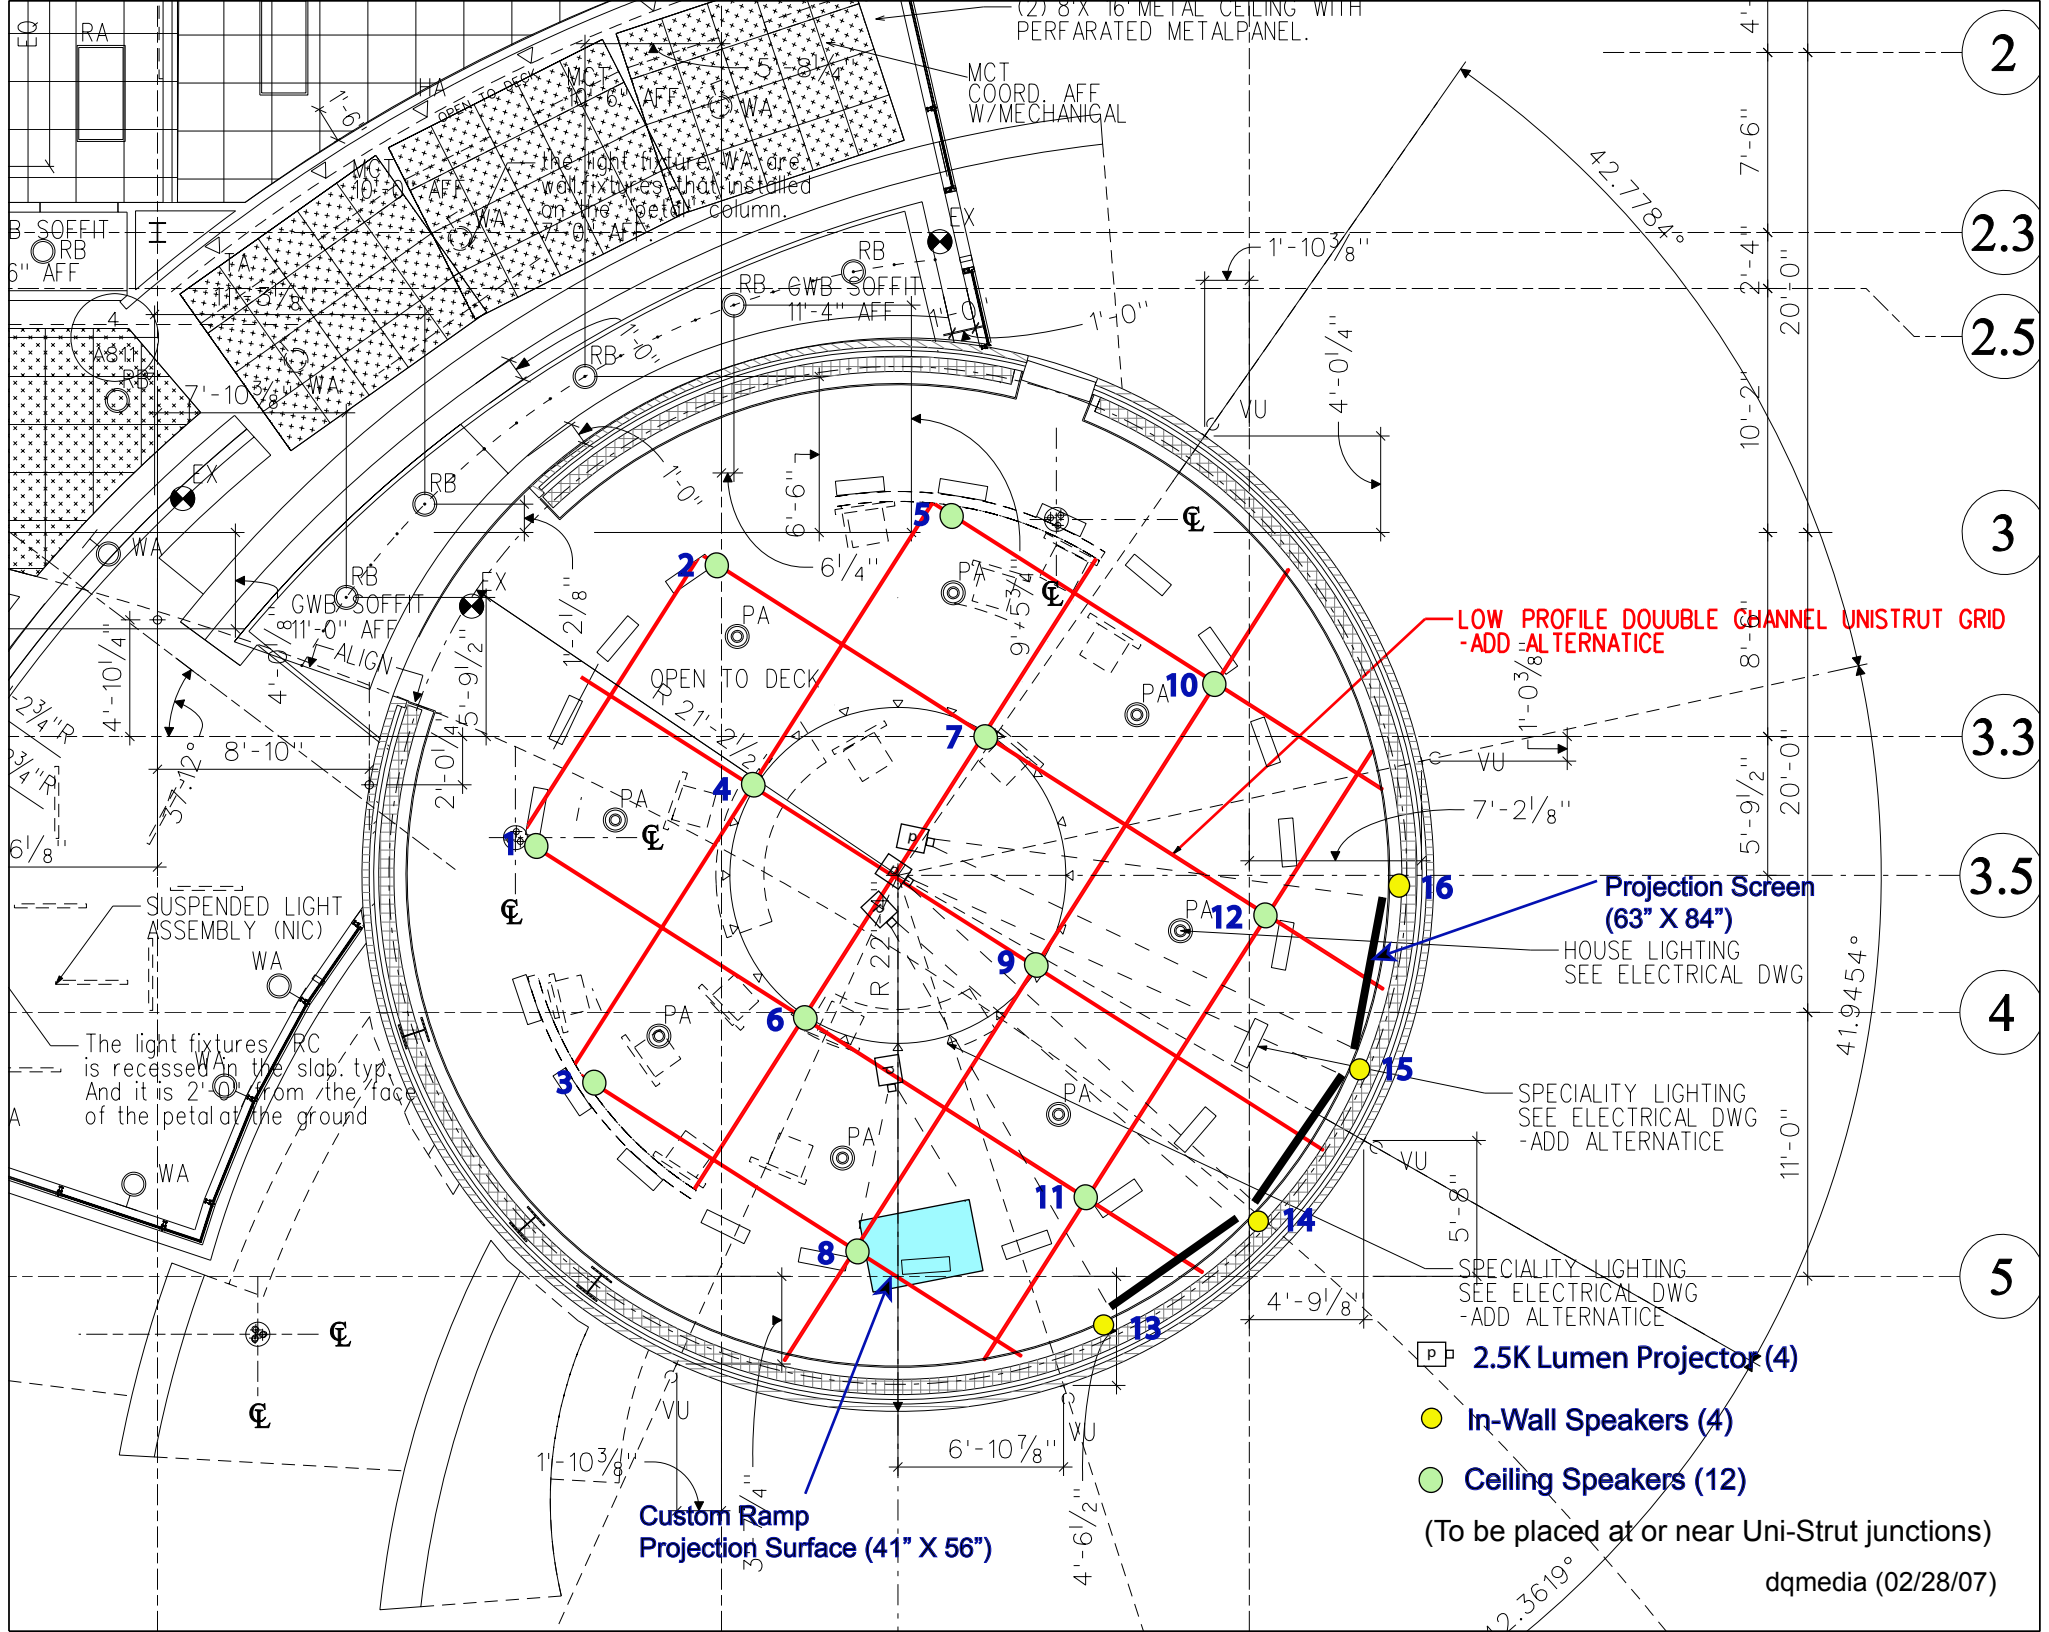

The light fixture WA are with fixtures that installed on the ceiling column.

SUSPENDED LIGHT ASSEMBLY (NIC)
 The light fixtures PC is recessed in the slab top And it is 2'-0" from the face of the petal at the ground

LOW PROFILE DOUBLE CHANNEL UNISTRUT GRID
 -ADD-ALTERNATICE

Projection Screen (63" X 84")
 HOUSE LIGHTING SEE ELECTRICAL DWG

SPECIALITY LIGHTING SEE ELECTRICAL DWG
 -ADD ALTERNATICE

SPECIALITY LIGHTING SEE ELECTRICAL DWG
 -ADD ALTERNATICE

2.5K Lumen Projector (4)

In-Wall Speakers (4)

Ceiling Speakers (12)

(To be placed at or near Uni-Strut junctions)

Custom Ramp Projection Surface (41" X 56")

HHRC Screen and In-Wall Speaker Sketch (01/29/07)



In-Wall Speakers (4)
 (JBL Control 128 W/WT)
 The speakers are to be mounted at 78" from the floor (O.C.)
 and covered with acoustically transparent matching fabric



Projectors (4)
 (Eiki XB 24)
 The projectors are to be mounted at 35" from the Uni-Strut (O.C.)

Ceiling/Top of Uni-Strut @ 11' 11"

Middle screen center aligned on axis with center of exhibit space entryway and inner wall/partition

